

REVISION
USE .1 SIZE TEXT ONLY

GENERAL NOTES
COORDINATES AND BEARINGS
REFER TO NEW YORK STATE
PLANE LONG ISLAND ZONE
(NAD83).

REVISION
SIGNATURES

REV

PROJ. NO. G-21-929/PHASE 10

conEdison

DWG. TYPE AS BUILT

DWG. SIZE E

LOCATION: SCARSDALE NY

SHEET 1 OF 3

TITLE: W22-100058854-P3
INTERSECTION OF FOX MEADOW RD & OGDEN RD

— APPROVALS —

SECTION MANAGER:



SUPERVISOR:

SURVEYOR: K. LINDE

DRAWN BY: K. LINDE

SCALE: AS NOTED


DISCIPLINE CODE: TU

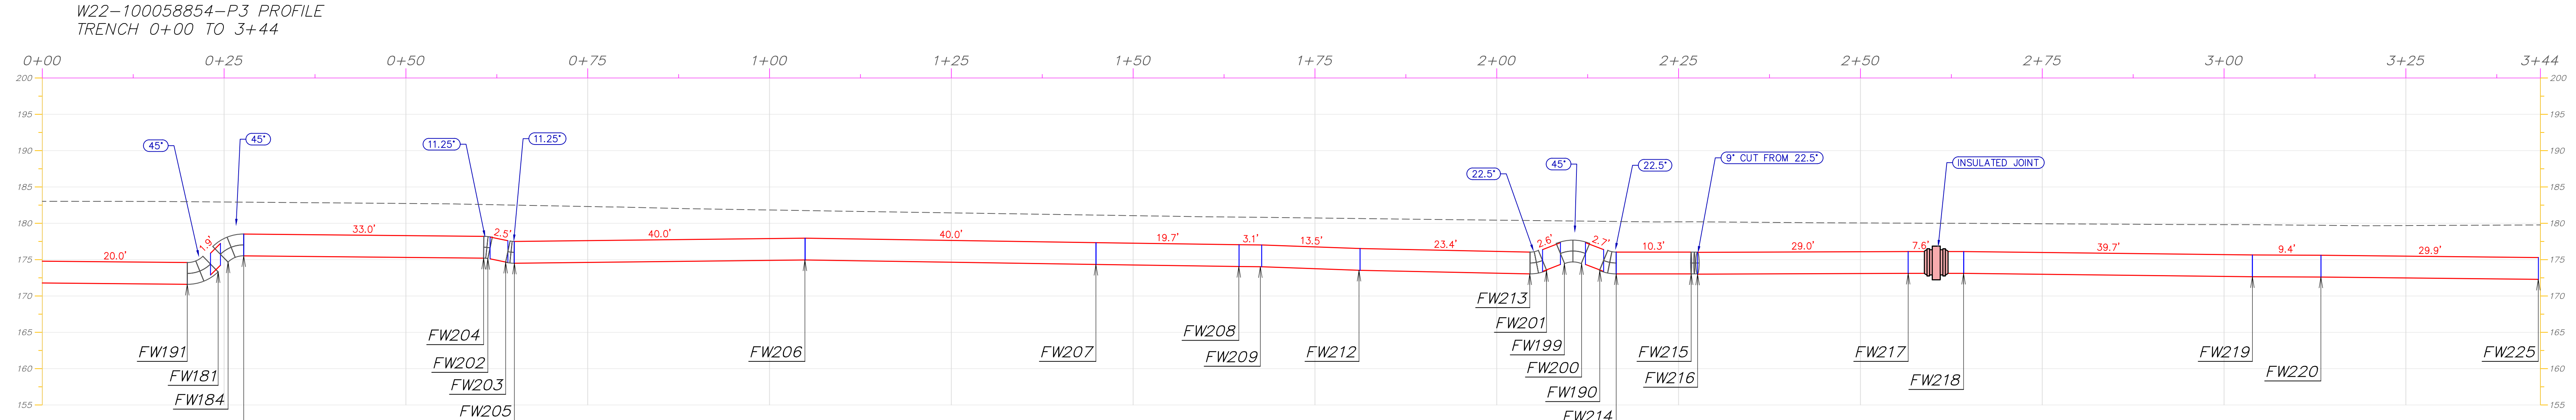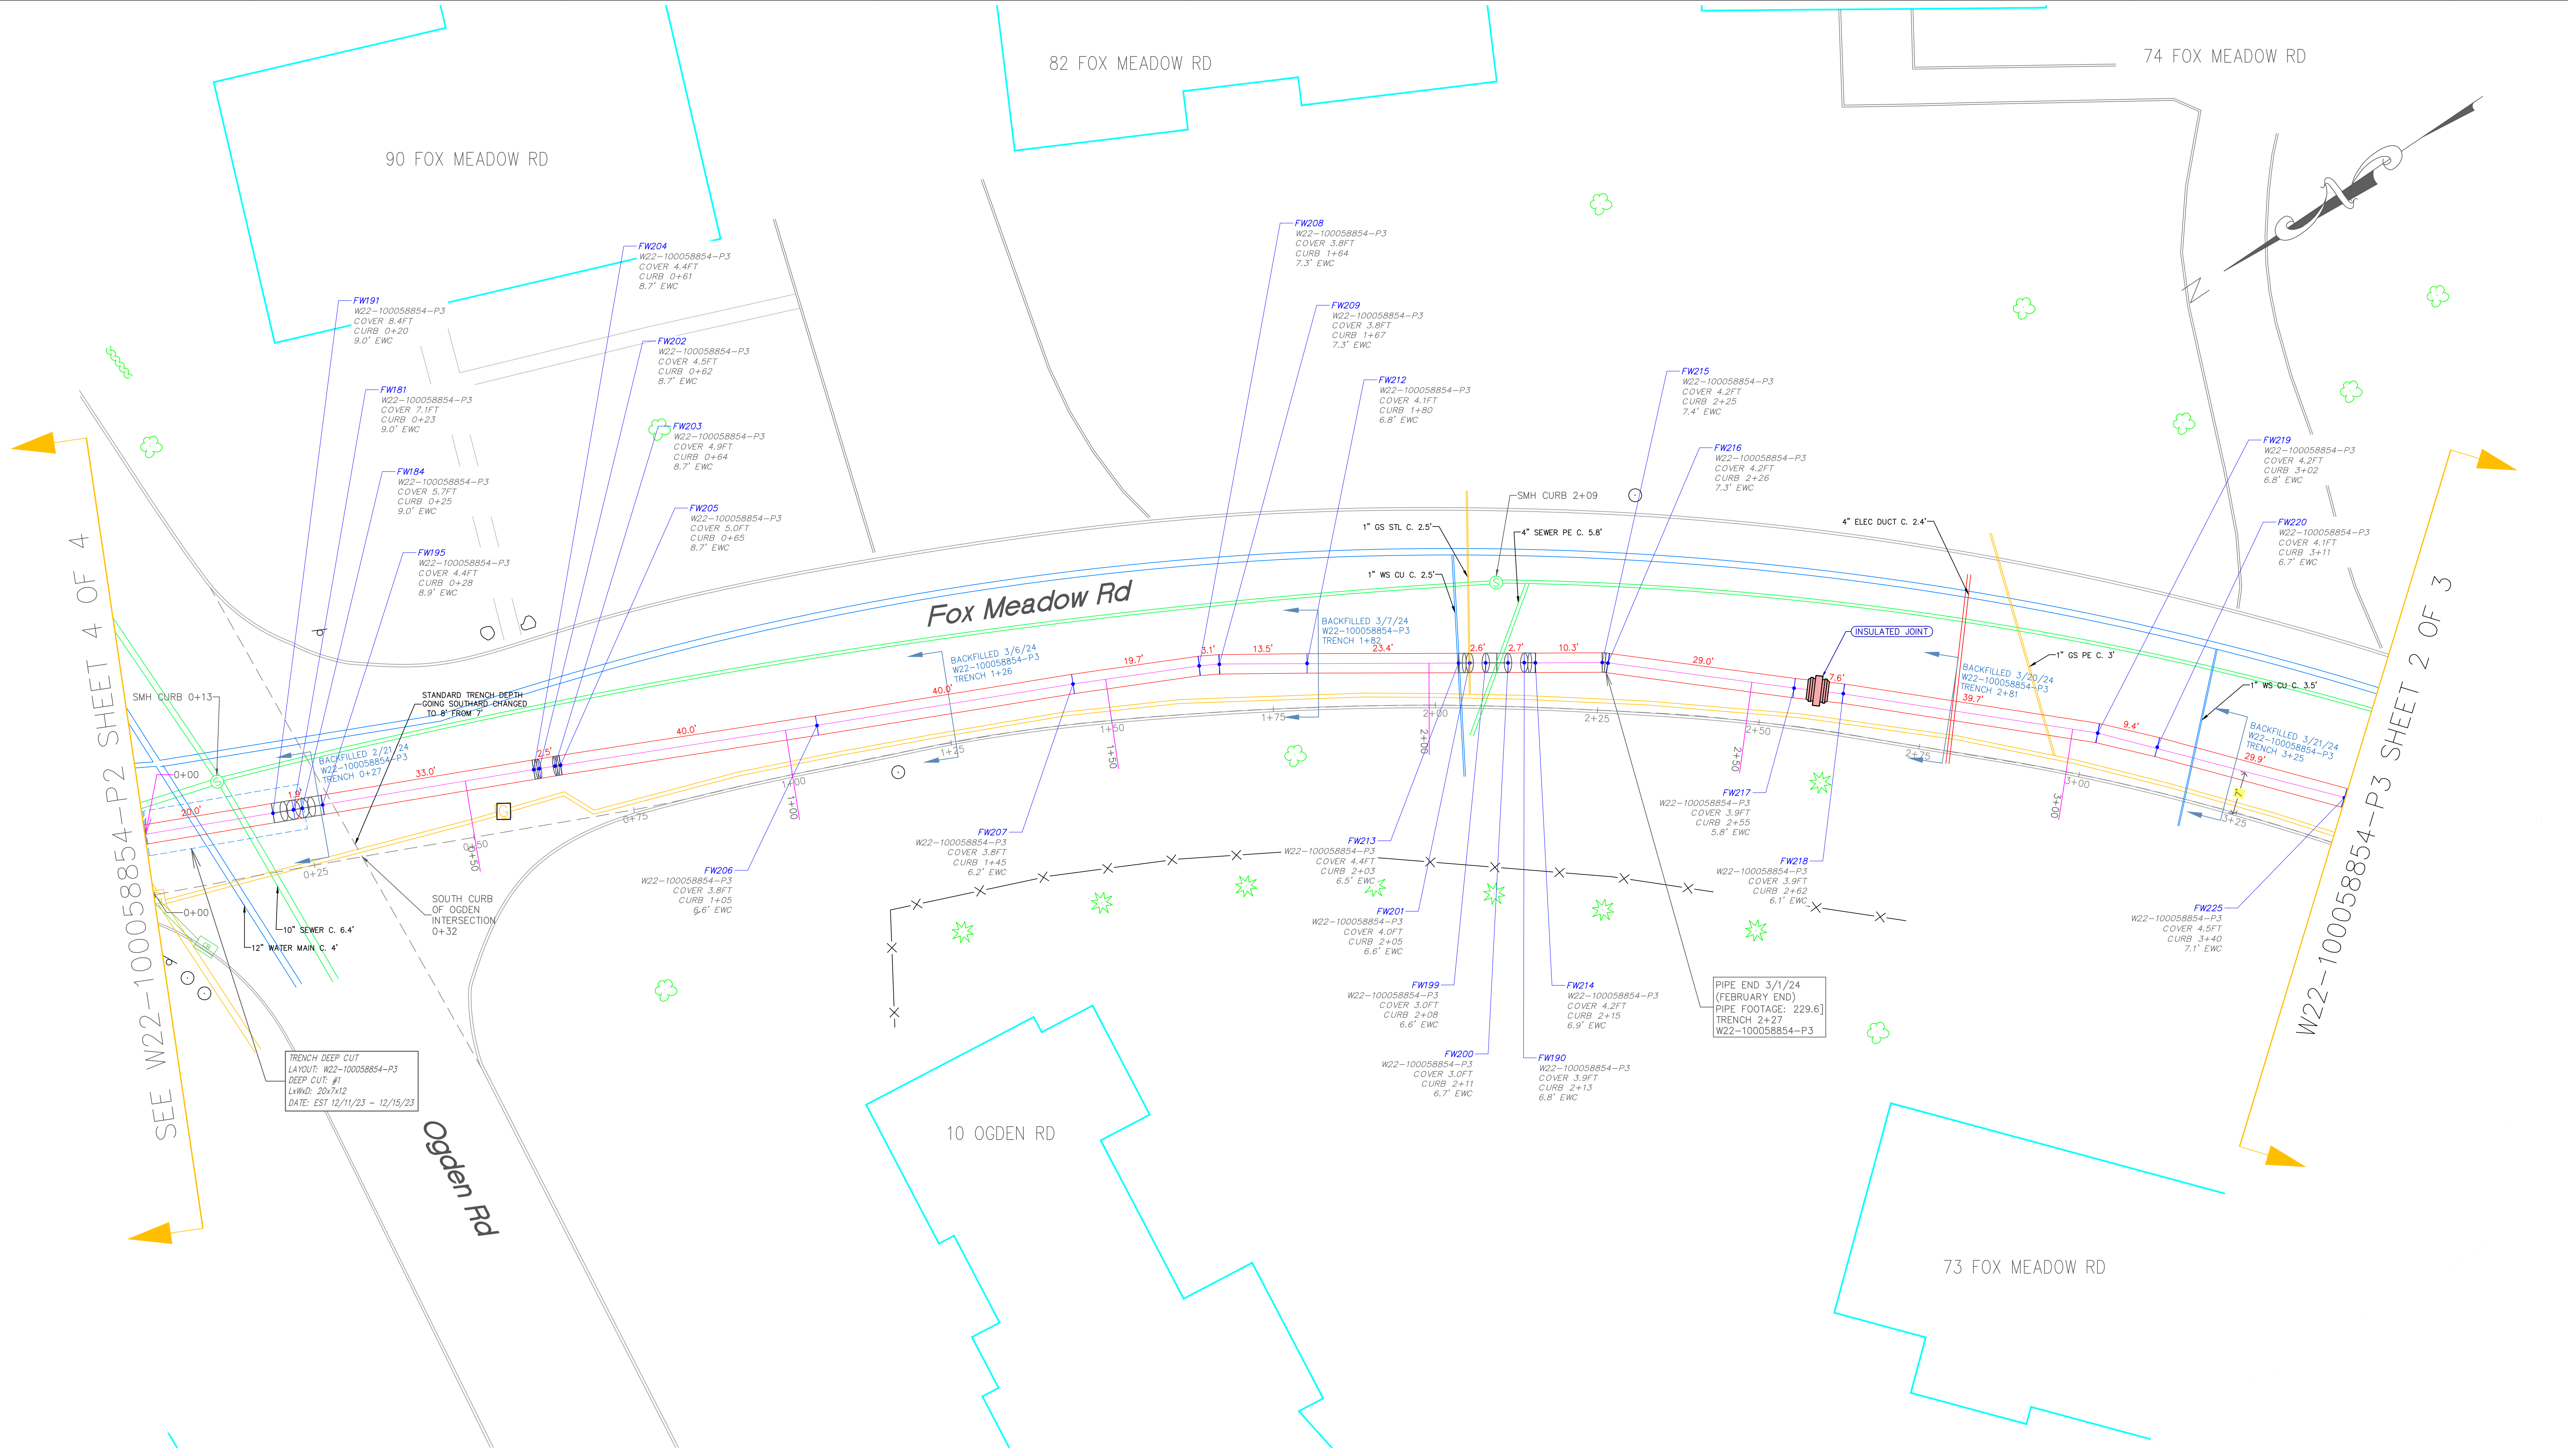

36" STL. GAS MAIN (TRANSMISSION) W22-100058854-P3 SHEET 1 OF 3							
COMPONENTS	11.25'	22.5'	45'	CUSTOM 9'	IJ	WELDS	PIPE FOOTAGE
AS-CONSTRUCTED	2	2	3	1	1	26	345.3



AS-CONSTRUCTED

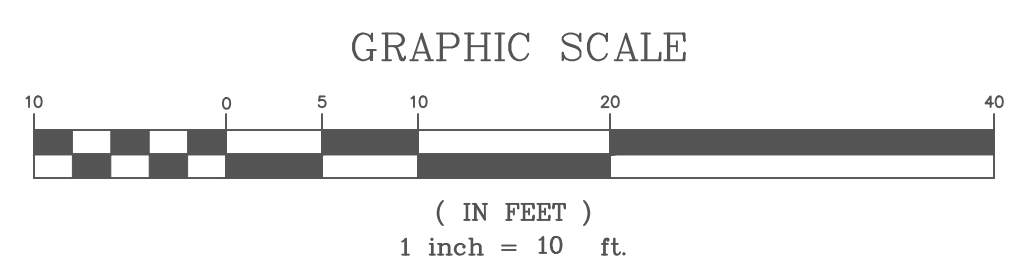

COMPUTER GENERATED DRAWING NOT TO BE HAND REVISED